
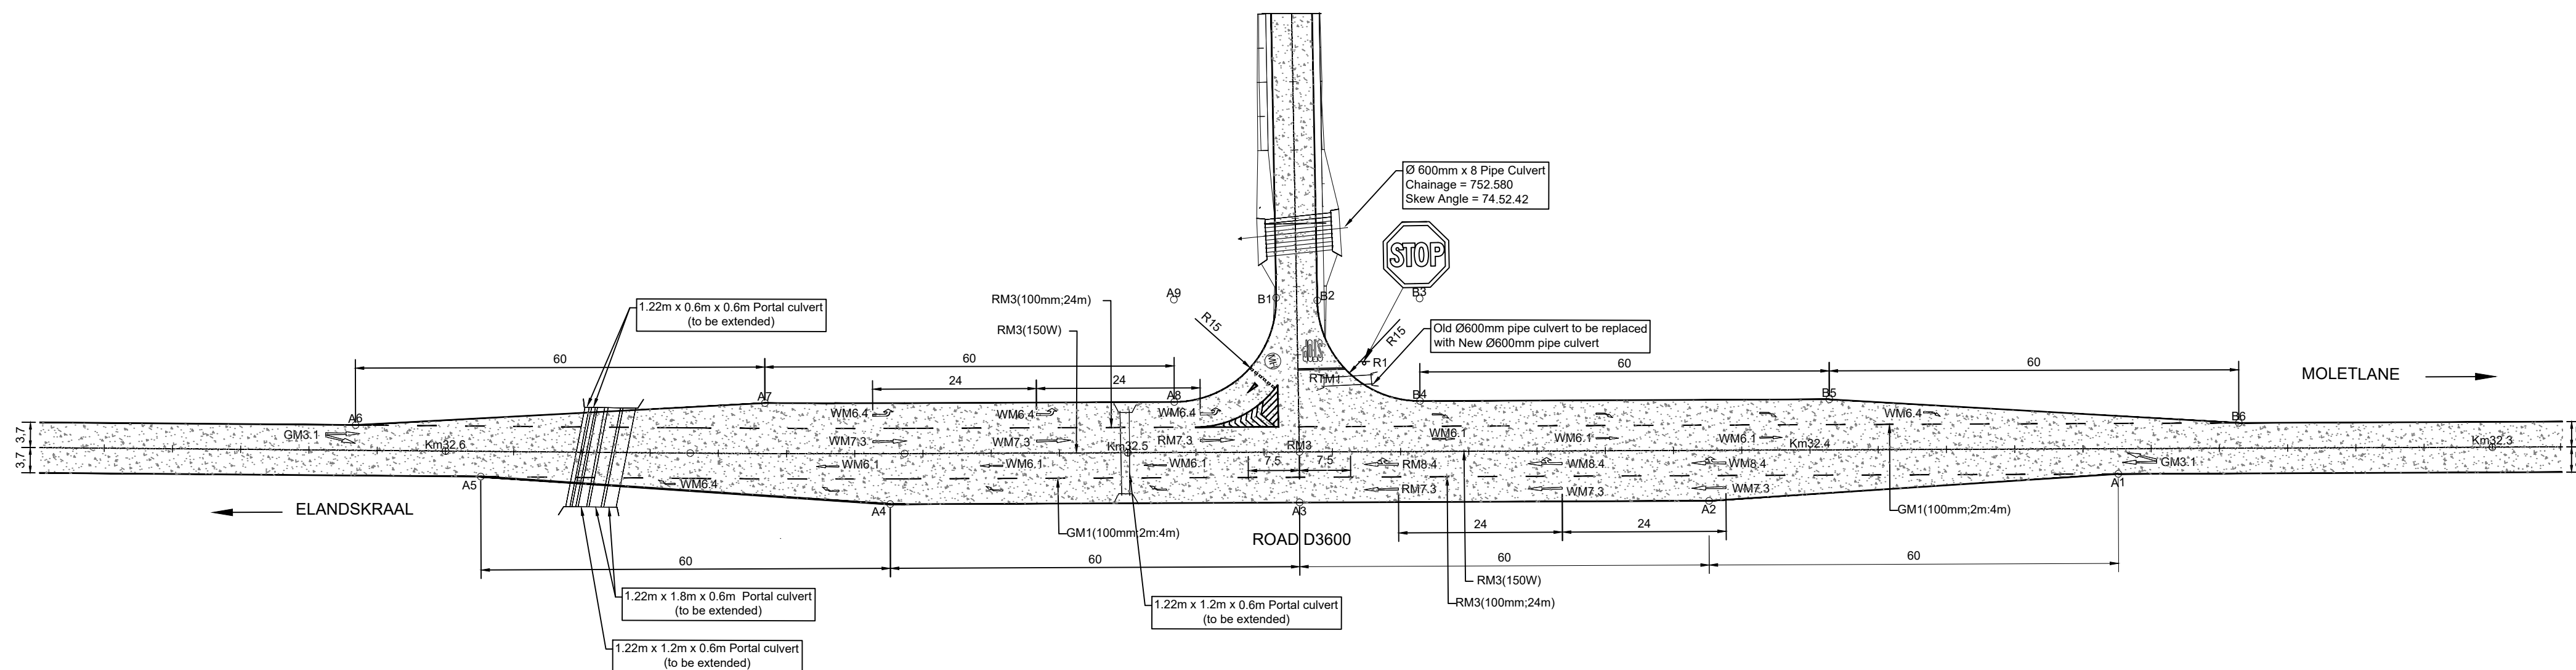
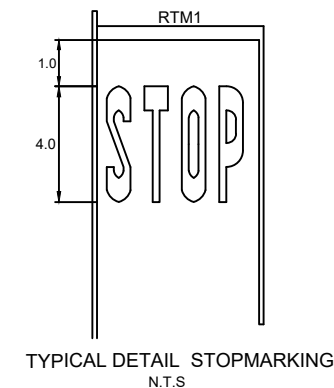


COORDINATES LIST (WGS 84 LO 31)			
INTERSECTION ROAD D3600 AND ROAD 4			
POINT	Y-COORD	X-COORD	RADIUS
A1	-47174.168	2722395.511	
A2	-47164.652	2722454.867	
A3	-47151.527	2722513.414	
A4	-47138.400	2722571.960	
A5	-47121.096	2722629.570	
A6	-47109.645	2722645.765	
A7	-47119.873	2722586.569	
A8	-47133.080	2722528.040	
A9	-47118.444	2722524.759	15m
B1	-47121.525	2722510.079	
B2	-47123.239	2722504.308	
B3	-47126.320	2722489.628	15m
B4	-47140.956	2722492.909	
B5	-47154.082	2722434.362	
B6	-47170.818	2722376.625	

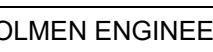

DESIGNED BY:	EM	AS BUILT PLAN Full Signatures ----- For Client 20 / / ----- For Consulting Engineer Consultant's Drawing No.: DE44/INT/02	APPROVED ----- For Client 20 / / ----- For Consulting Engineer DECEMBER 2018	<table><tr><td>NO.</td><td>REVISION DETAILS</td><td>REV NO</td><td>DATE</td><td>REVISED BY</td><td>APPRVD BY</td></tr><tr><td>00</td><td>FOR INFORMATION PURPOSE</td><td>00</td><td>03/2021</td><td></td><td></td></tr><tr><td></td><td></td><td></td><td></td><td></td><td></td></tr><tr><td></td><td></td><td></td><td></td><td></td><td></td></tr><tr><td></td><td></td><td></td><td></td><td></td><td></td></tr><tr><td></td><td></td><td></td><td></td><td></td><td></td></tr></table>	NO.	REVISION DETAILS	REV NO	DATE	REVISED BY	APPRVD BY	00	FOR INFORMATION PURPOSE	00	03/2021																											<table><tr><td>DRAWING STATUS</td><td></td></tr><tr><td>For Information Purpose</td><td>☒</td></tr><tr><td>For Tender Purpose</td><td>☐</td></tr><tr><td>For Construction</td><td>☐</td></tr><tr><td>For Asbuilt</td><td>☐</td></tr></table>	DRAWING STATUS		For Information Purpose	☒	For Tender Purpose	☐	For Construction	☐	For Asbuilt	☐	 LEPELLE-NKUMPI LOCAL MUNICIPALITY PRIVATE BAG X07 CHUENESPOORT 0745 Tel: 015 633 4500 Fax: 015 633 6896	DOLMEN ENGINEERS  P.O. BOX 1209 FAUNA PARK 0787 Tel: 015 295 4885 Fax: 015 295 8384	CONTRACT NUMBER: LNM002/2019/20 PROJECT NAME: UPGRADING OF ACCESS ROAD FROM GRAVEL TO TAR - KLIPHUIWEL - WARD 01 INTERSECTION:ROAD D3600 AND ROAD 3 LAYOUT PLAN	SHEET 2 of 3 SCALE: AS SHOWN CLIENT DRAWING NO: LNM002/2019/20/INT/02 REVISION 00
NO.	REVISION DETAILS		REV NO	DATE	REVISED BY	APPRVD BY																																																	
00	FOR INFORMATION PURPOSE		00	03/2021																																																			
DRAWING STATUS																																																							
For Information Purpose	☒																																																						
For Tender Purpose	☐																																																						
For Construction	☐																																																						
For Asbuilt	☐																																																						
DRAWN BY:	TM																																																						
CHECKED BY:	MP																																																						
ISSUED BY:	MP																																																						